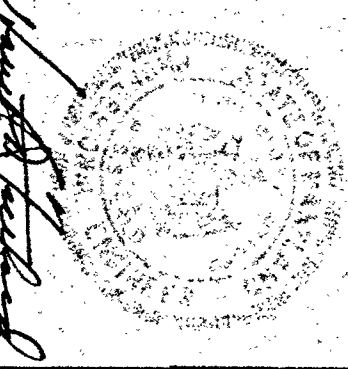
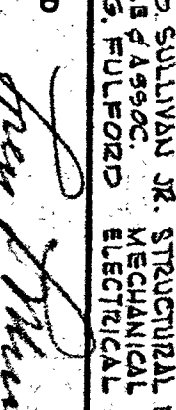

FLOOR PLAN LIGHTING
 SCALE: 1/8"=1'-0"

NOTES

1. SEE DRAWING NE E-1 for SYMBOLS and SPECIAL NOTES.
2. SEE DRAWING NE E-4 for SCHEDULES and DETAILS.
3. SEE DRAWING NE E-3 for ADDITIONAL WORK.

 JAMES B. SULLIVAN, JR. ELECTRICAL ENGINEER No. 10,000 State of Maryland	JOHANNES & MURRAY & ASSOCIATES ARCHITECTS 1000 WASHINGTON DRIVE, SUITE 200 WASHINGTON, D.C. 20004 PHONE (202) 462-1000 FAX (202) 462-1001	CONTINUING EDUCATION BUILDING ALLEGANY COMMUNITY COLLEGE CUMBERLAND, MARYLAND
APPROVED  JAMES B. SULLIVAN, JR.	DRAWN E-2 5-1-77	