


THRUST BLOCK DETAIL

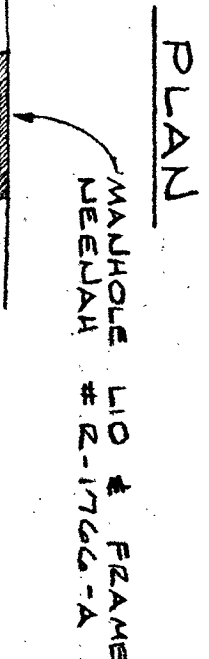


SECTION _____


MANHOLE _____

DETAIL _____


NO. _____ SCALE _____

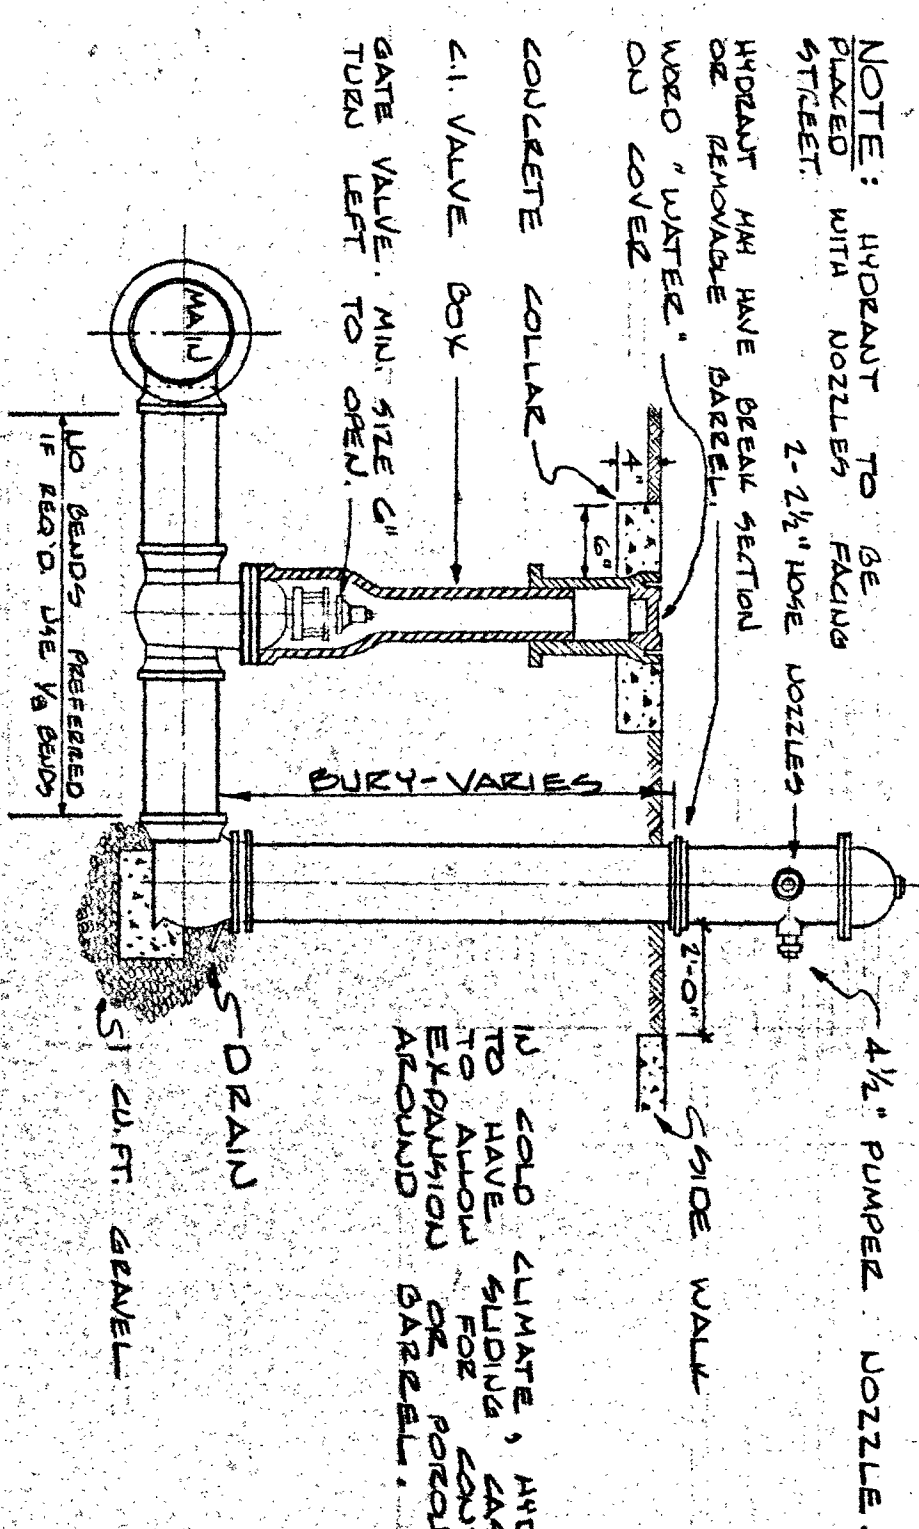




HYDRAUNT DETAIL

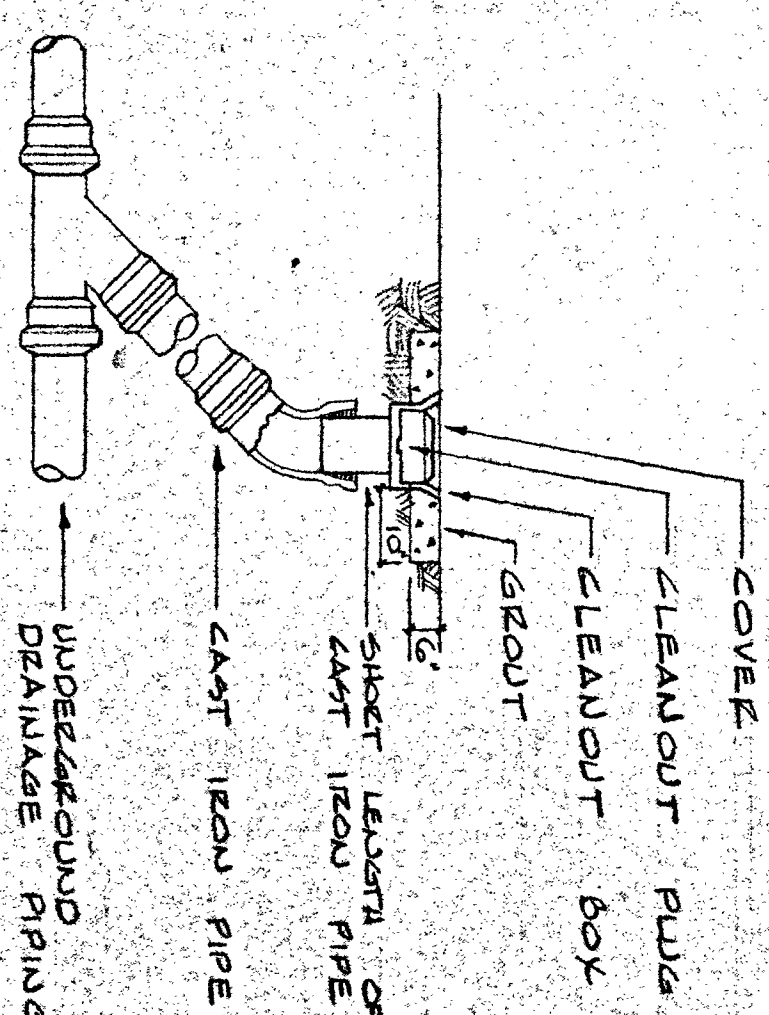

EXTERIOR CLEANOUT
IN GRASS AREA
NO SCALE

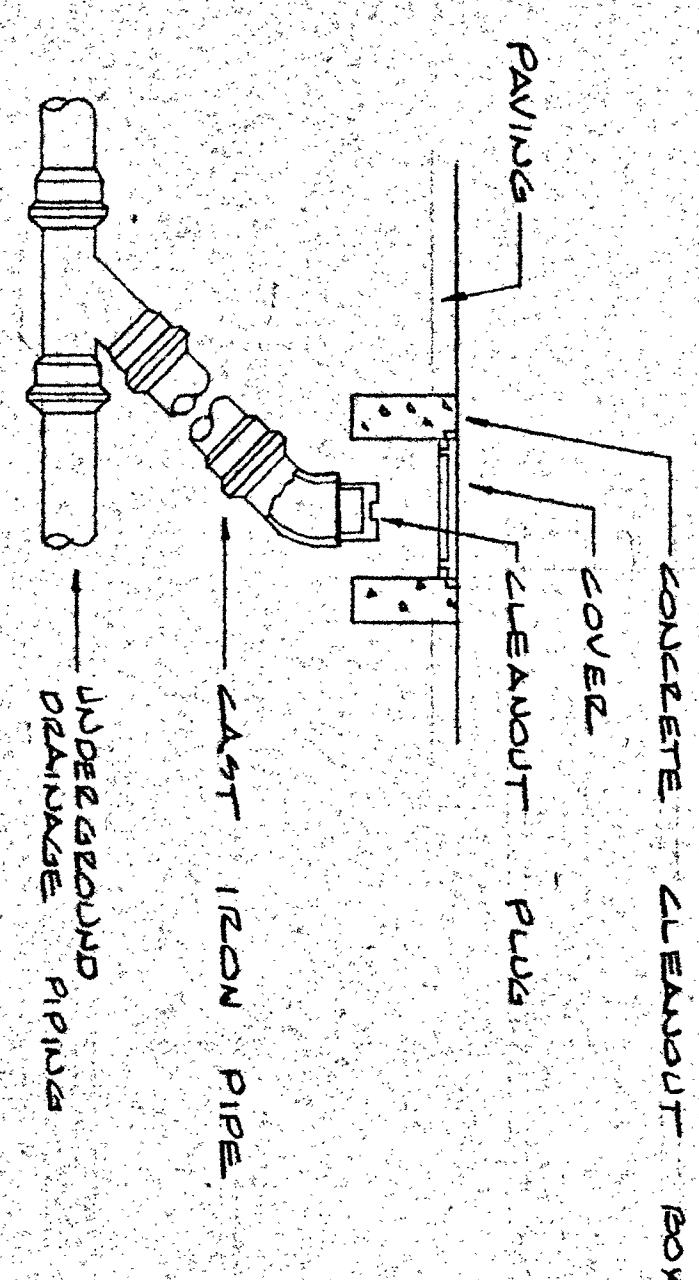

EXTERIOR CLEANOUT
UNPAVED AREA

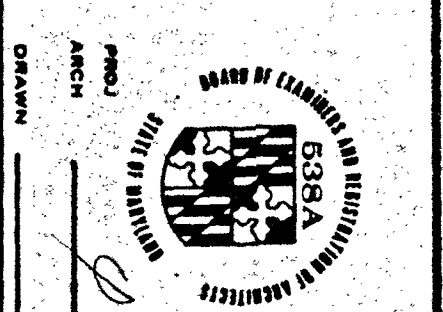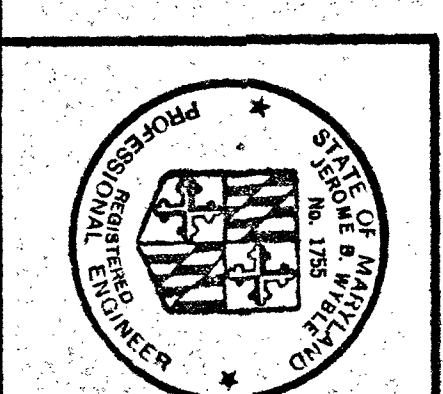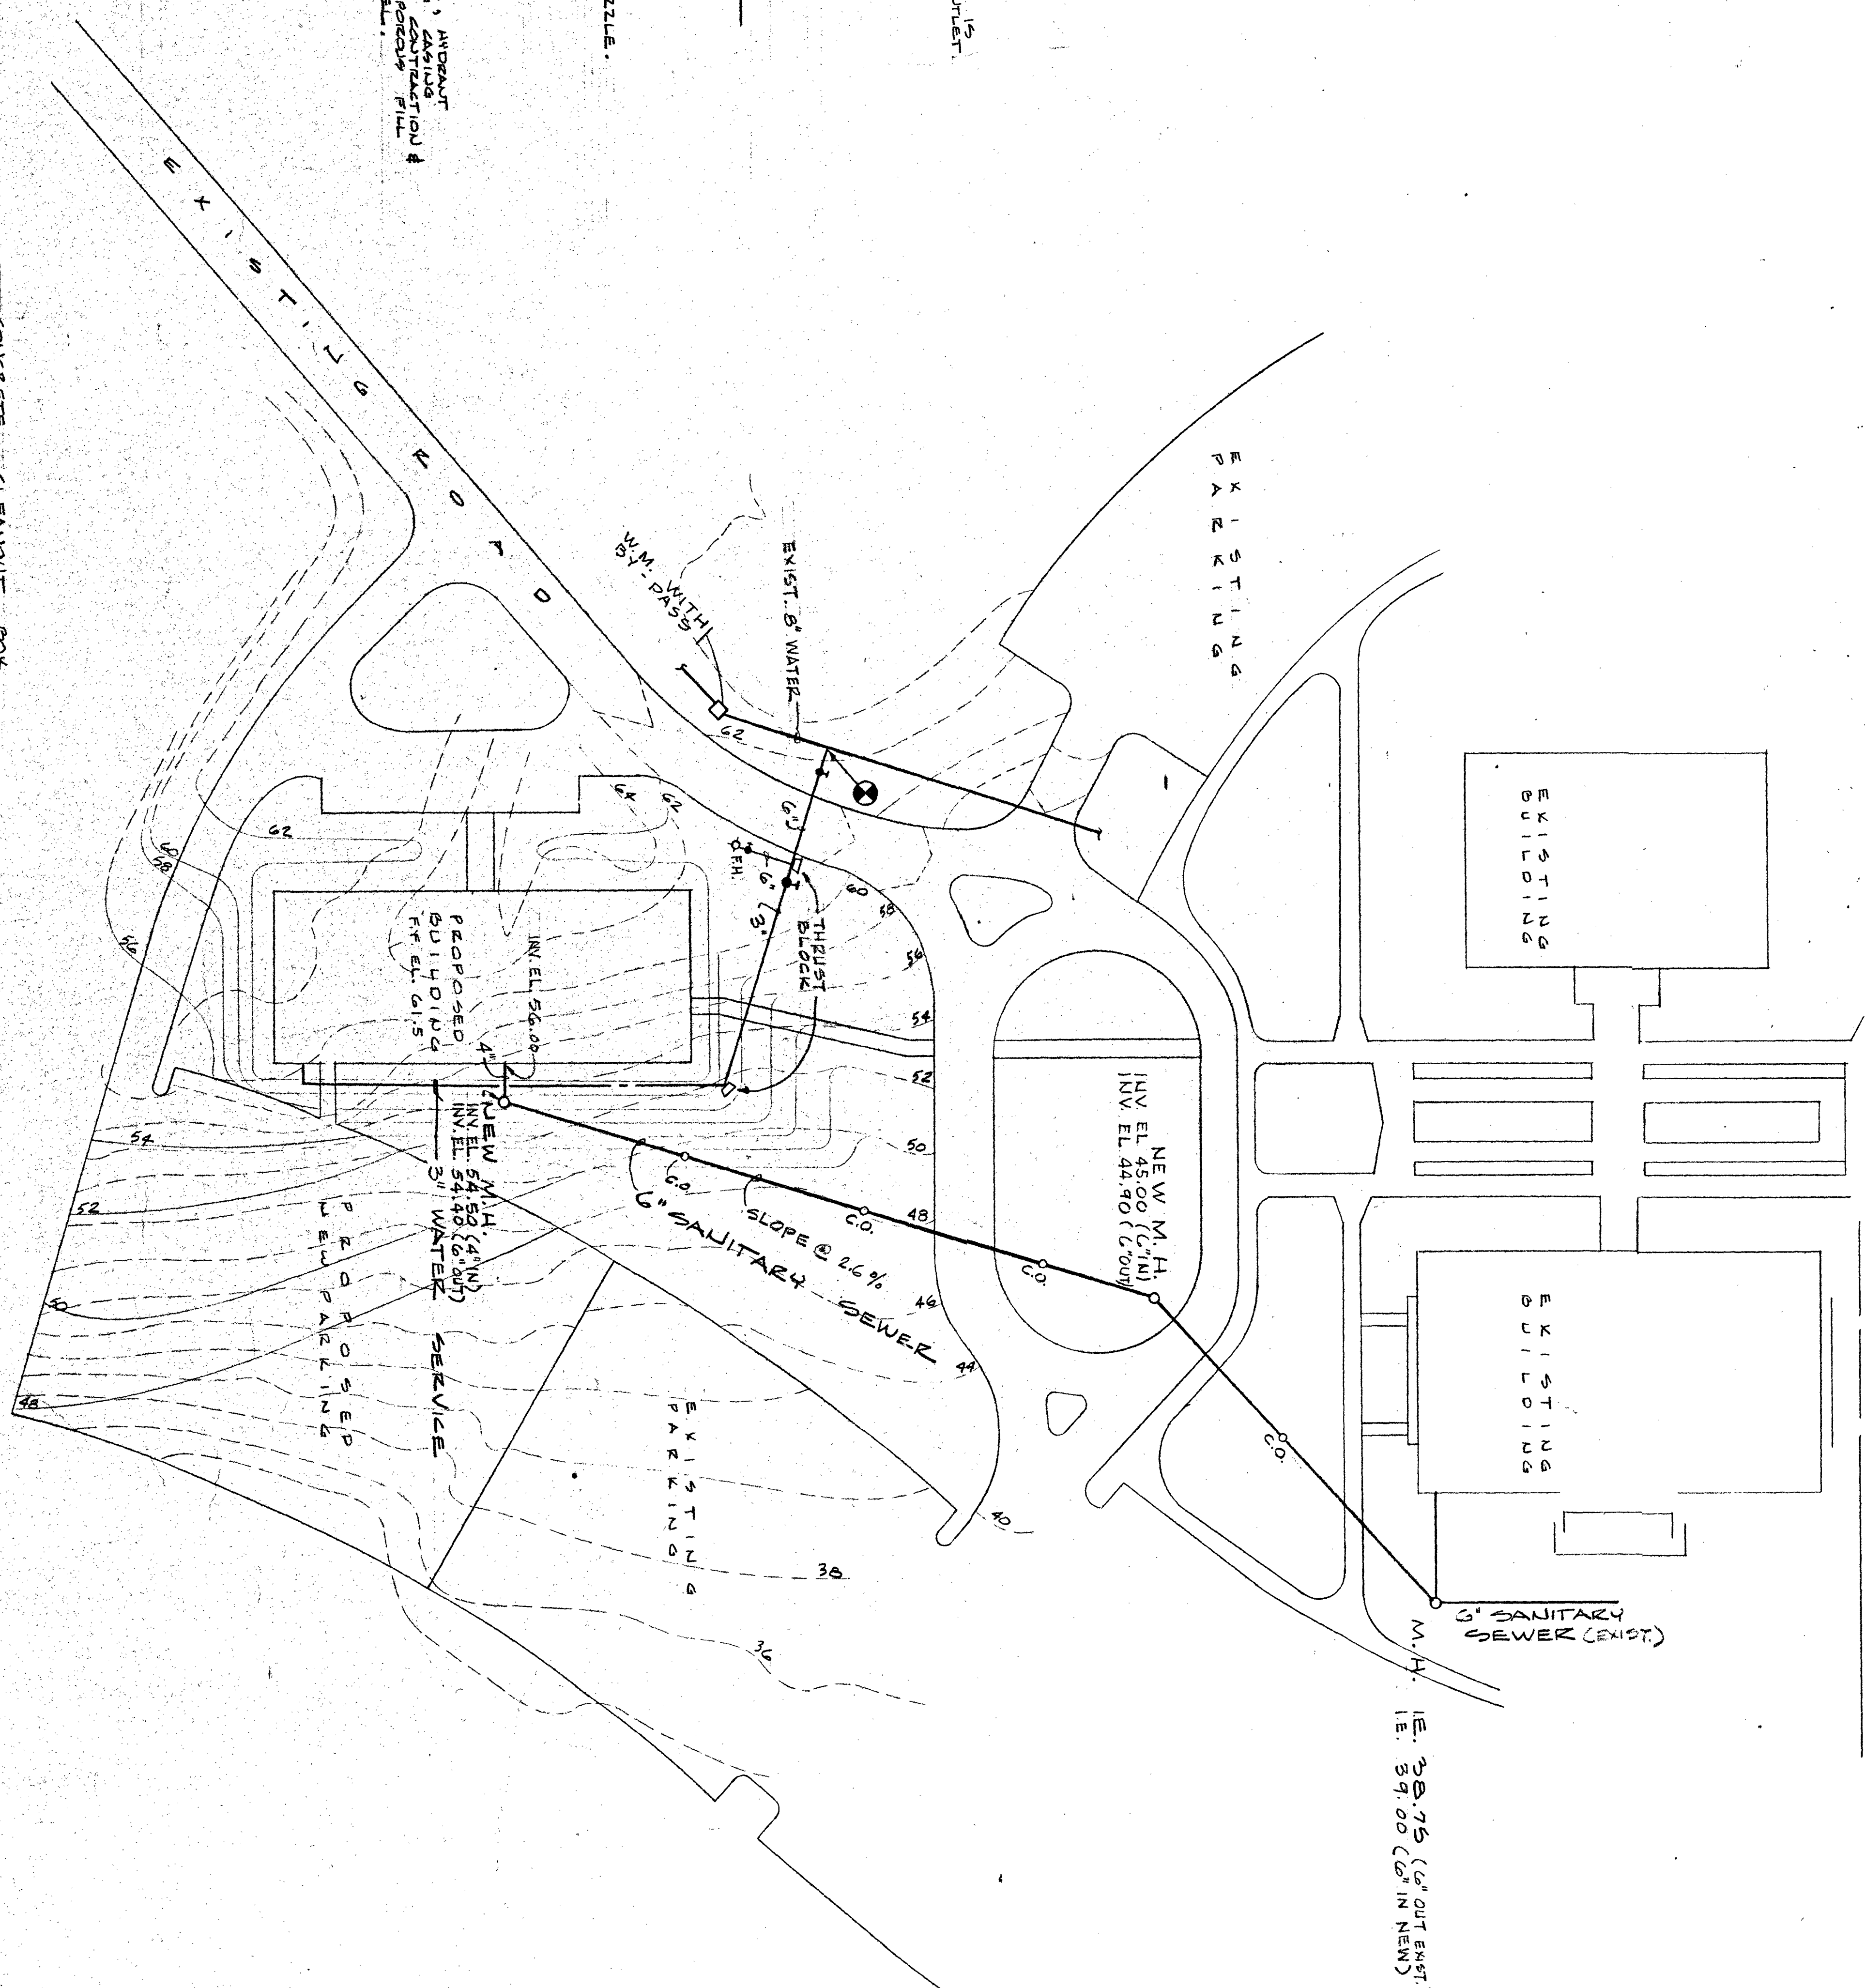

JOHANNES & MURRAY & ASSOCIATES
REGISTERED ARCHITECTS
SILVER SPRING, MARYLAND
808 PERSHING DRIVE JU 9-3792
JAMES R. SULLIVAN JR. STRUCTURAL ENGINEER
JAMES R. SULLIVAN JR. ELECTRICAL ENGINEER
HARDY G. RUFORD ELECTRICAL ENGINEER
APPROVED
John J. Murray

CONTINUING
EDUCATION
BUILDING -
ALLEGANY COMMUNIT
CUMBERLAND, MAR21

Joe A	638. A	P-1	of	P2	DATE	3-1-77
-------	--------	-----	----	----	------	--------