

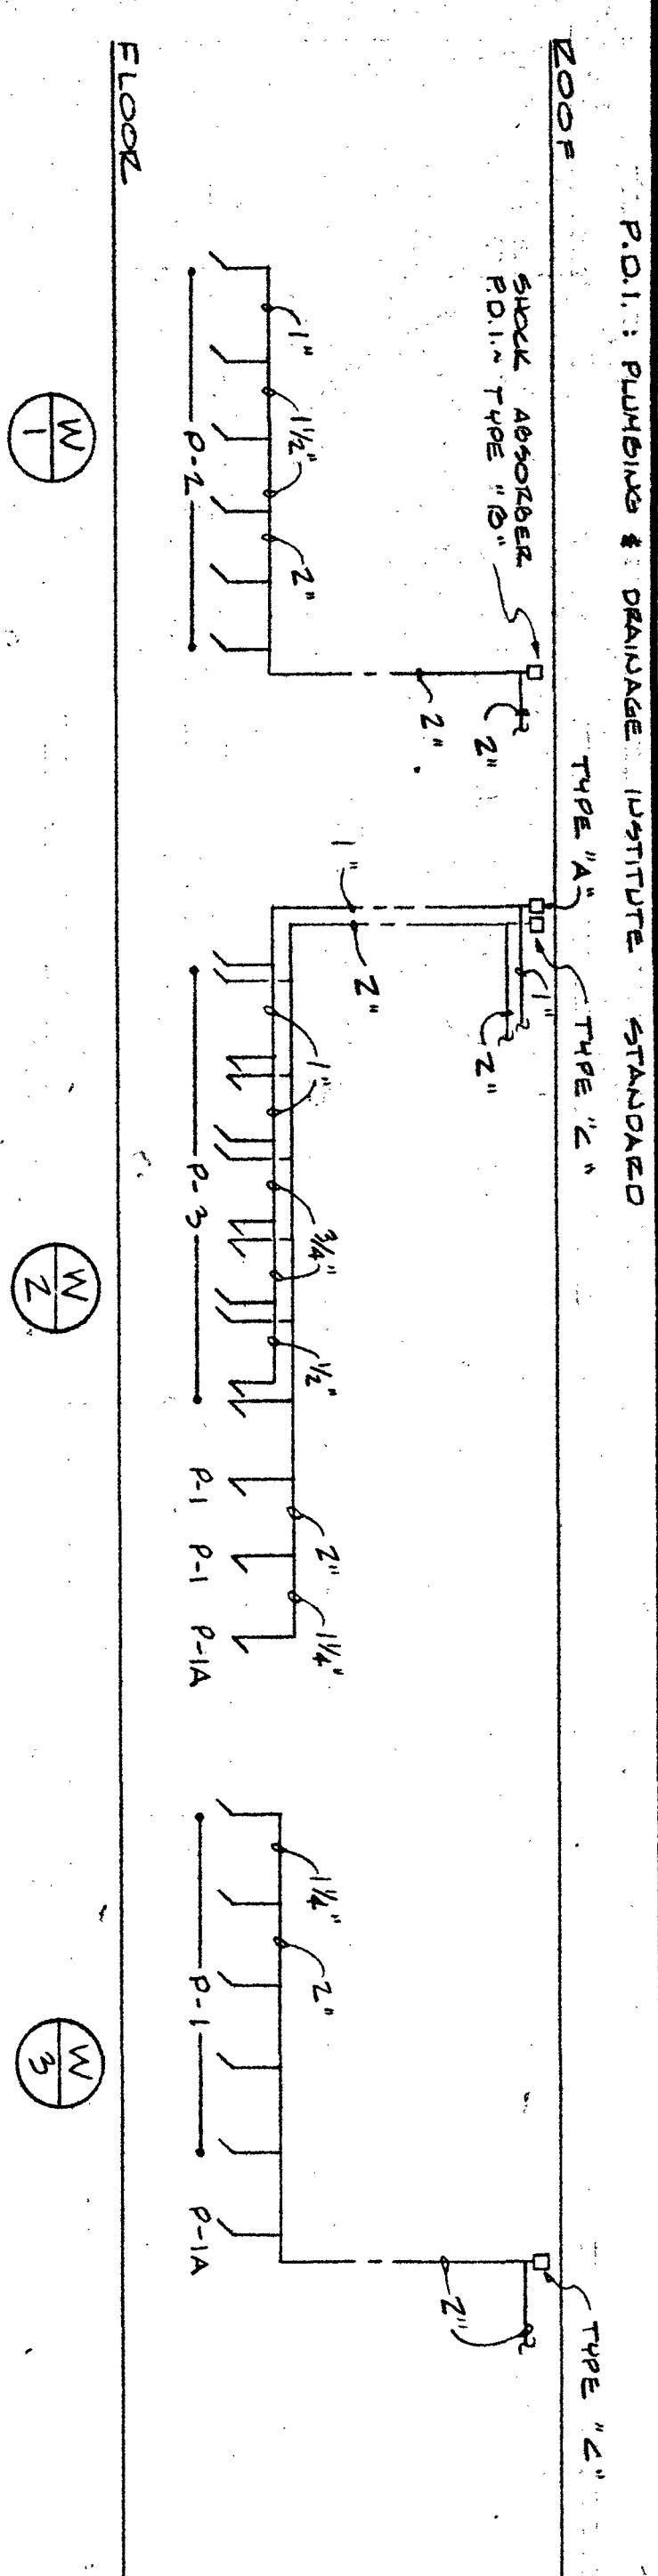
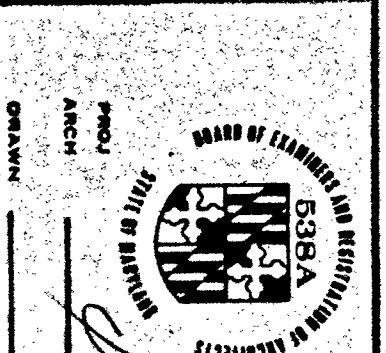


Symbols	#	ABBREVIATIONS
_____	C.W	COLD WATER PIPES
_____	H.W	HOT " "
_____	H.W.C	HOT " CIRCULATING
_____	V	VENT PIPES
_____	SOIL OR WASTE PIPES	
○_____	ELBOW	ROUND
○_____	ELBOW	UP
— —C—	W.H.	WALL HANGING
— —	G.V.	GATE VALVE
— —	C.V	CHECK VALVE
— —	F.O.	FLOOR DRAIN
□_____	V.T.E.	VENT TRAP ROOF
⊕	WATER	UNDER DISTRIBUTION
⊕	WATER	UNDER DISTRIBUTION
⊕	WATER	UNDER DISTRIBUTION

FIXTURE			CONNECTION			SCHEDULE		
ID	FIXTURES	WASTE	ENT	EW	AW	REMARKS		
P-1	WATER CLOSET	4"	2"	1 1/2"	—	REGULAR		
P-1A	"	4"	2"	1 1/2"	—	HAND LAPPED		
P-2	URINAL	2"	2"	2"	—	WALL HUNG		
P-3	LAVATORY	1 1/2"	1 1/2"	1 1/2"	1 1/2"	WALL HUNG		
P-4	SINK	1 1/2"	1 1/2"	1 1/2"	1 1/2"	BOTH IN & COM ONLY		
P-5	SERVICE SINK	3"	2"	1 1/2"	1 1/2"			
P-6	SERVICE SINK	3"	2"	1 1/2"	1 1/2"			
P-7	ELECTRIC WATER COOLER	1 1/2"	1 1/2"	1 1/2"	1"	WALL HUNG		
P-8	WASH FOOTBATH	2"	1 1/2"	1 1/2"	1"	SEMI-CIRCULAR 3/8"		

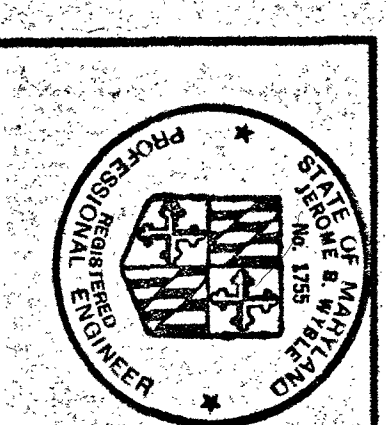

WATER PIPING ZISER DIAGRAM

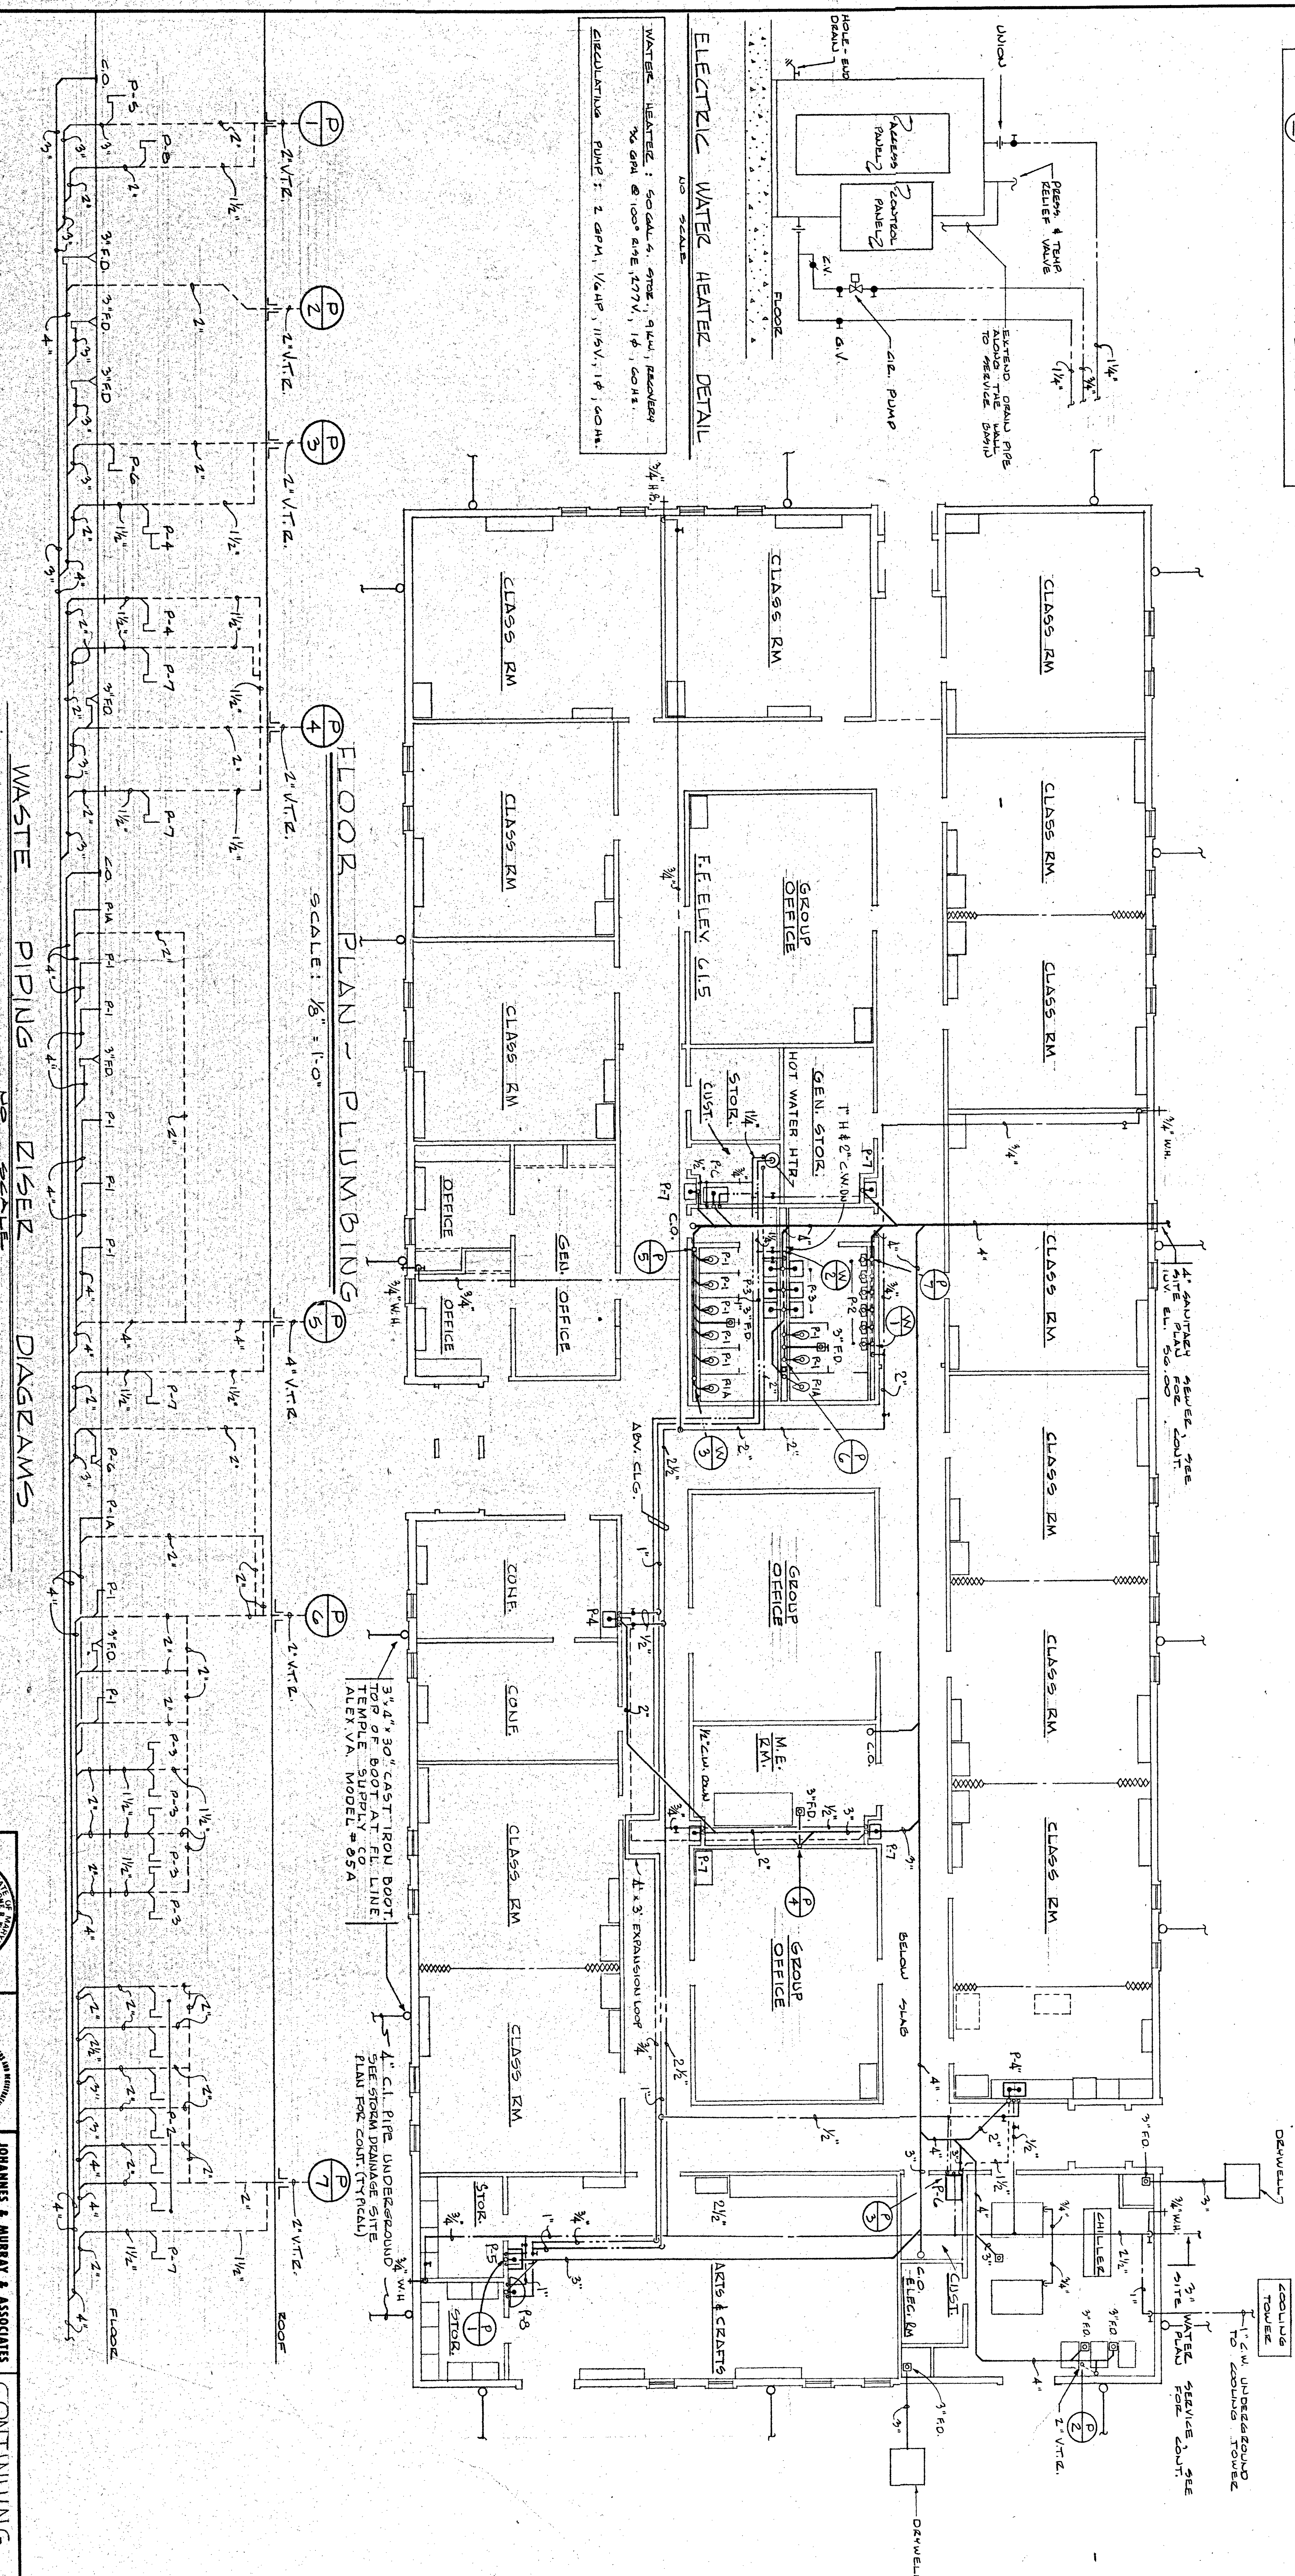

JOHANNES & MURRAY & ASSOCIATES
REGISTERED ARCHITECTS
SILVER SPRING, MARYLAND
685 PERSHING DRIVE JU 5-3789
JAMES B. SULLIVAN JR. STRUCTURAL ENGINEER
110 N. WYOMING & BLOSSOM
HARRIS & FIDOROW ELECTRICAL ENGINEER
APPROVED *John J. McHenry*

CONTINUING
EDUCATION
BUILDING.

638-A	SHEET	P-2	P-2
3.1.77	DATE		