


EXTERIOR DOORS & FRAMES

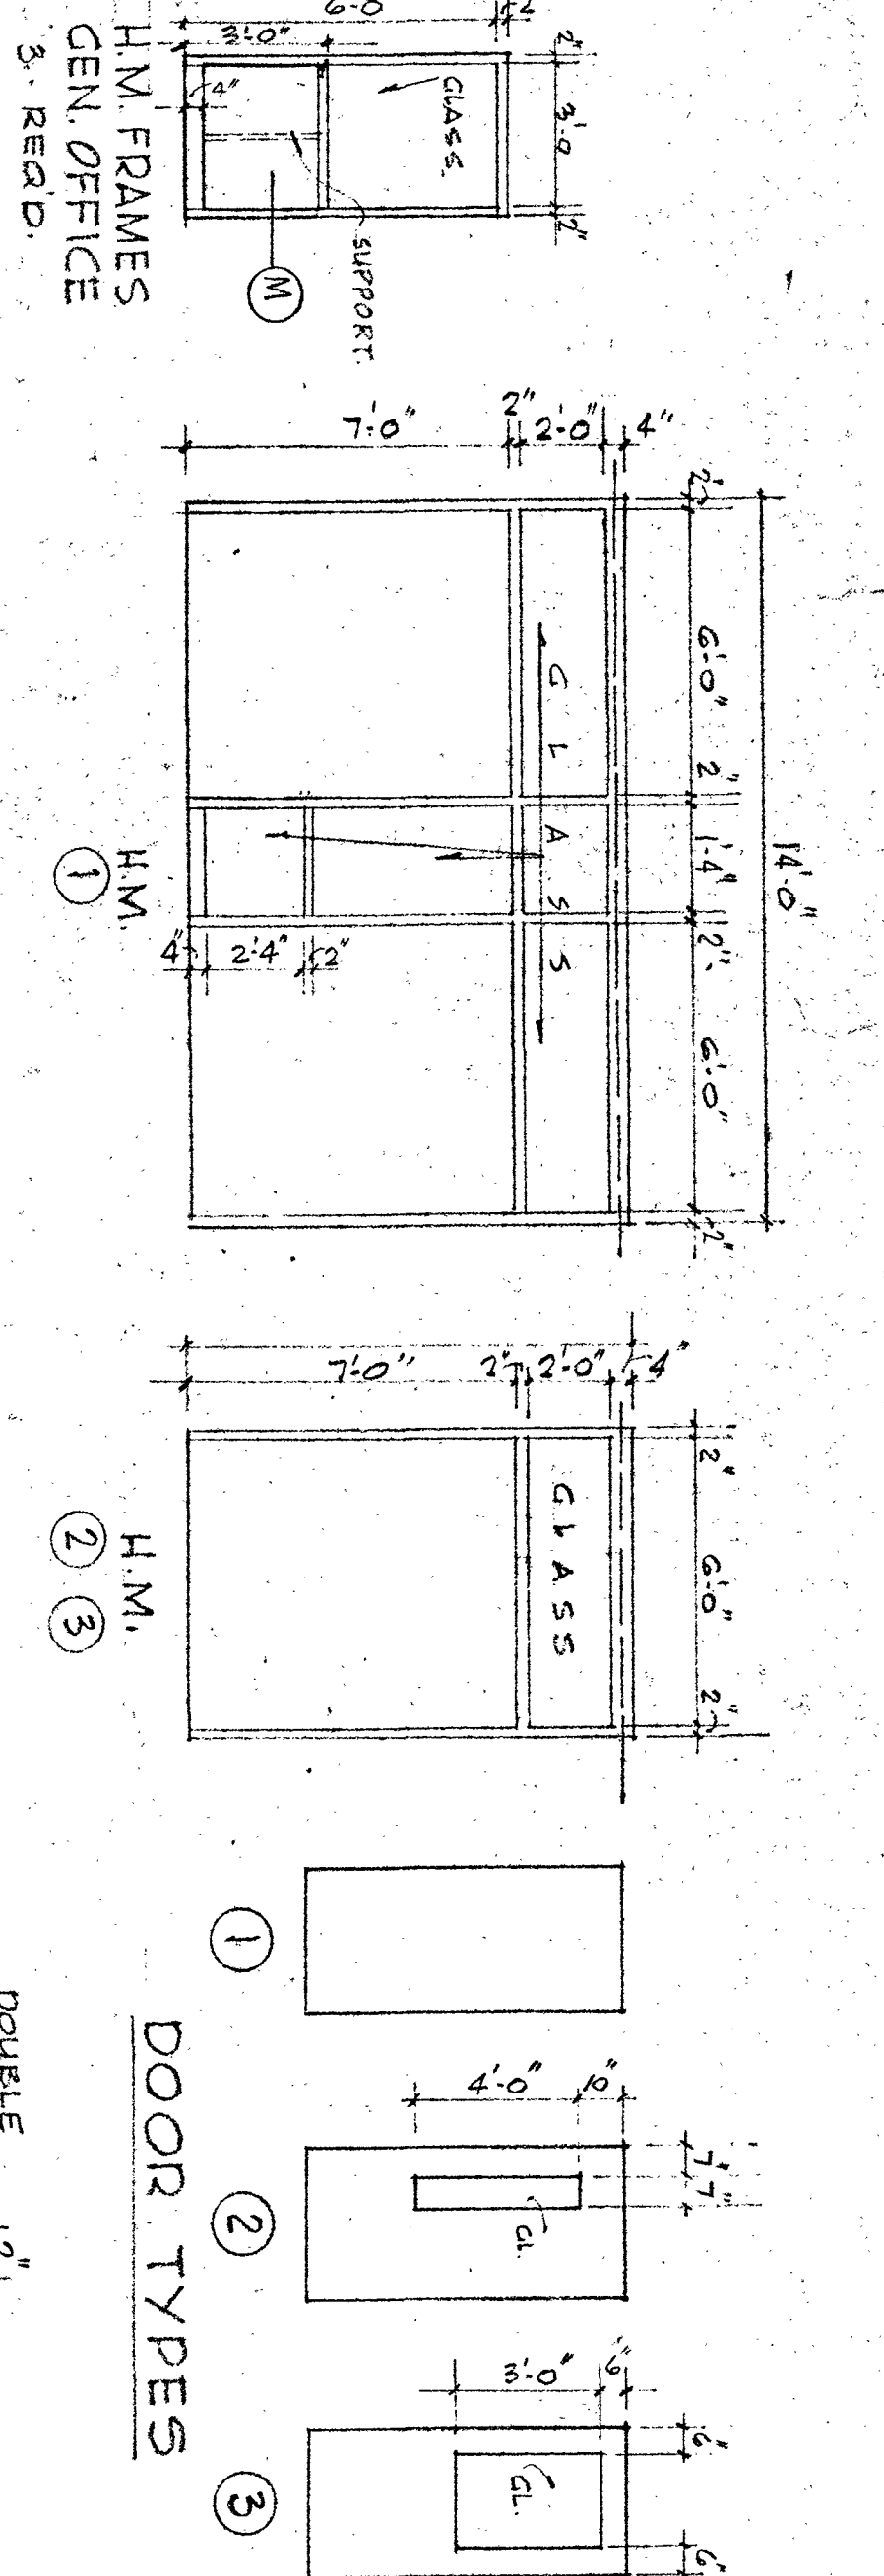

SPECIAL INTERIOR DOOR FRAMES


TYPICAL INTERIOR DOOR COLUMN JAMB

SCHEDULE INTERIOR DOORS

NO.	SIZE	MAT. TYPE	REMARKS
1	3'0" x 7'0"	WD	PAIR
2	3'0" x 10'0"	WD	PAIR
3	3'0" x 10'0"	WD	PAIR
DOOR NOTES

1. ALL DOORS 1 1/2" THICKNESS.
2. ALL GLAZING SHALL BE 1/2" POLISHED WIRE GLASS.
3. NO FRAMES EXTEND BELOW 4" UNDERCUT.
4. MARK ON PLAN INDICATES PRELIMINARY.
5. ALL WOOD DOORS SHALL BE PRELIMINARY.

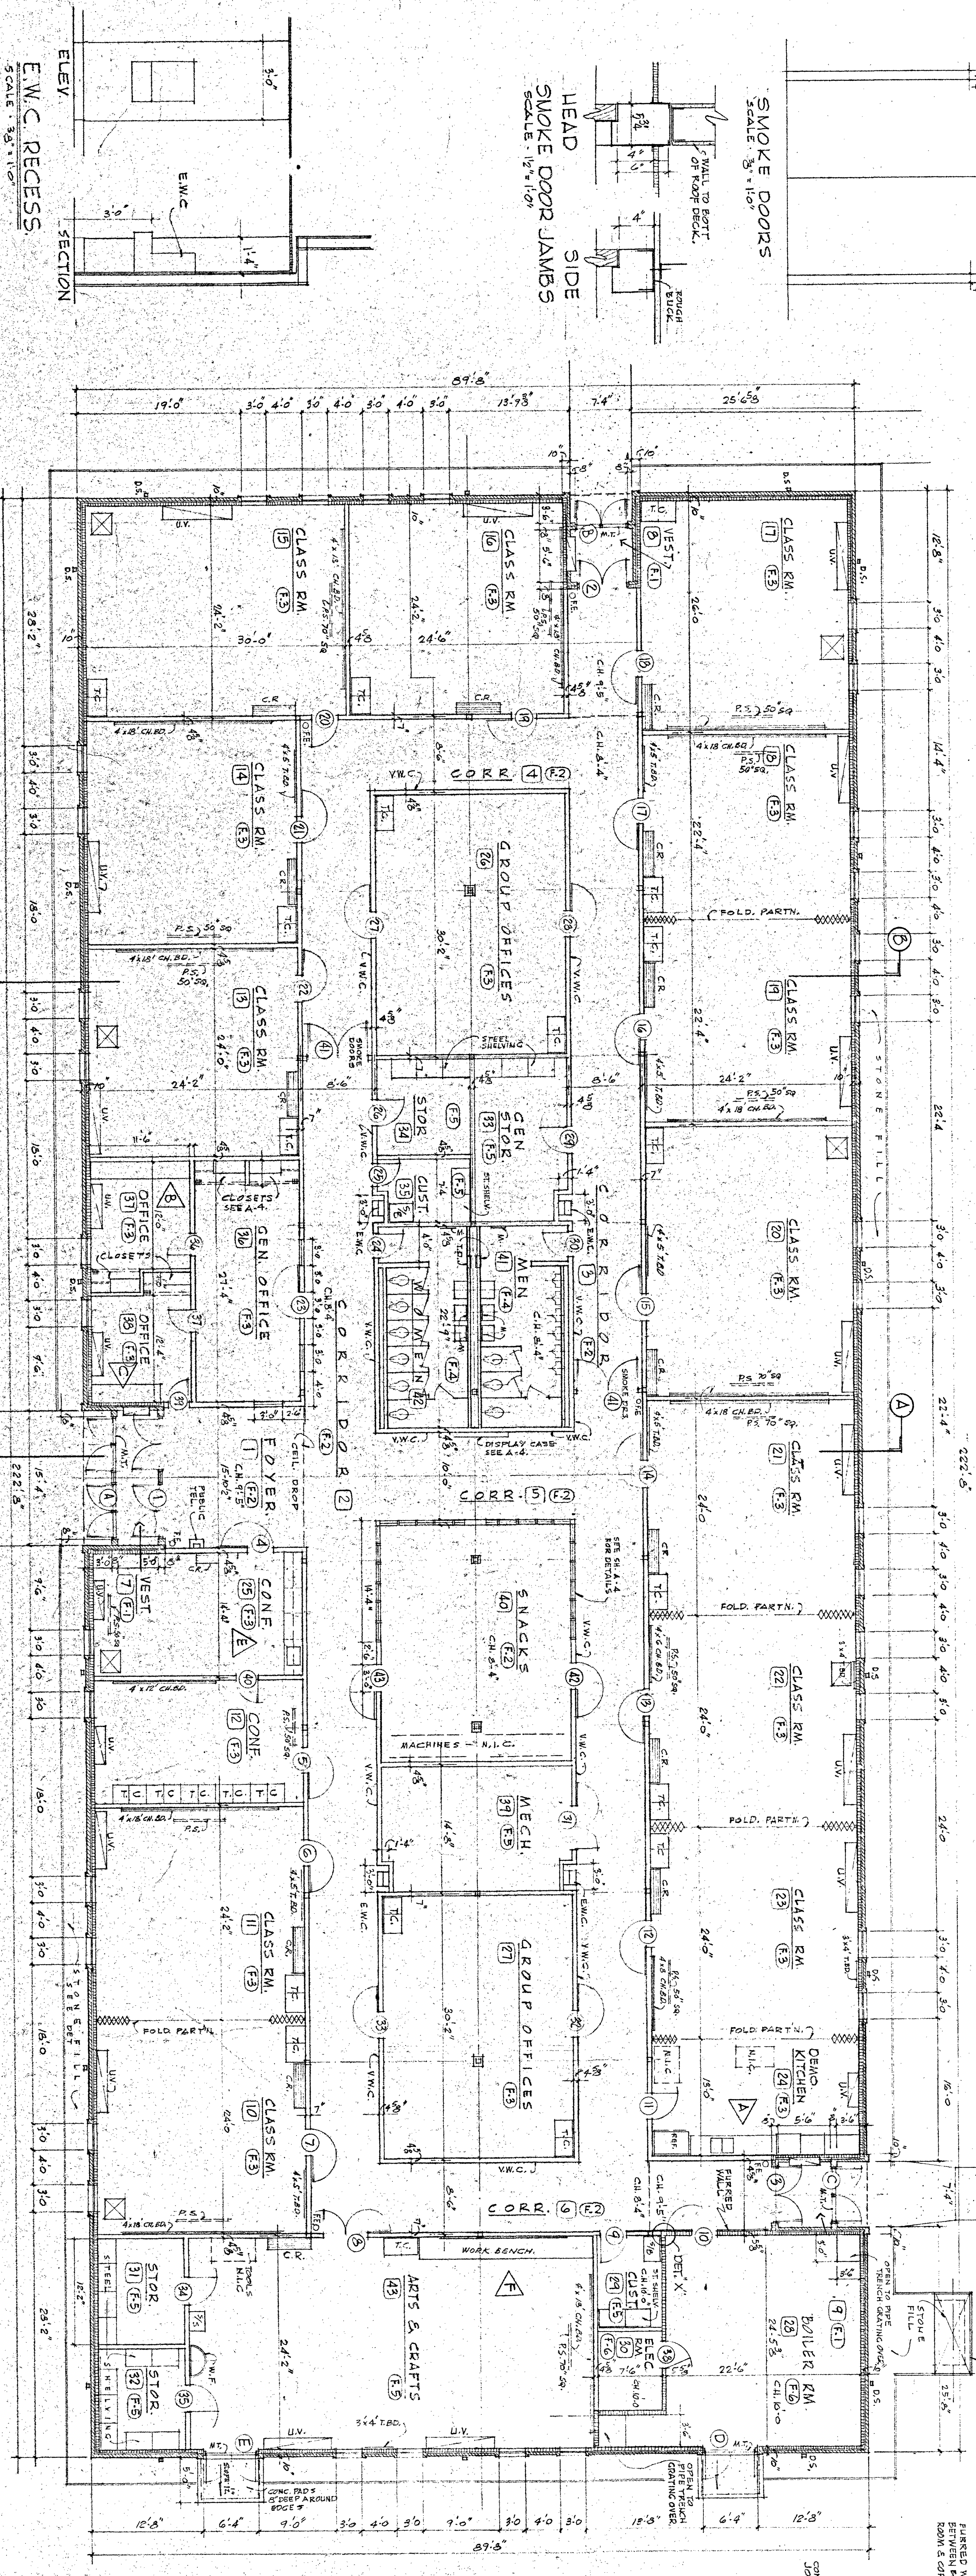


FLOOR PLAN

ROOM FINISH SCHEDULE



FLOOR	BASE	WALLS	CEILING	REMARKS
F1	V.A.T.	BRICK	A.T.	
F2	CARP.	DRY W.	A.T.	*T.W.C. SEE AS-COM. SCHEM.
F3	CARP.	DRY W.	A.T.	
F4	C.T.	DRY W.	A.T.	
F5	V.A.T.	DRY W.	A.T.	
F6	CONC.	BLK.	PLASTER	

ABBREVIATIONS:

CARP. CARPET
V.A.T. VINYL ASBESTOS TILE
C.T. CERAMIC TILE
RUE. RUBBER
BLK. BLOCK
W. WALL
CONC. CONCRETE
T.W.C. VINYL WALL COVERING

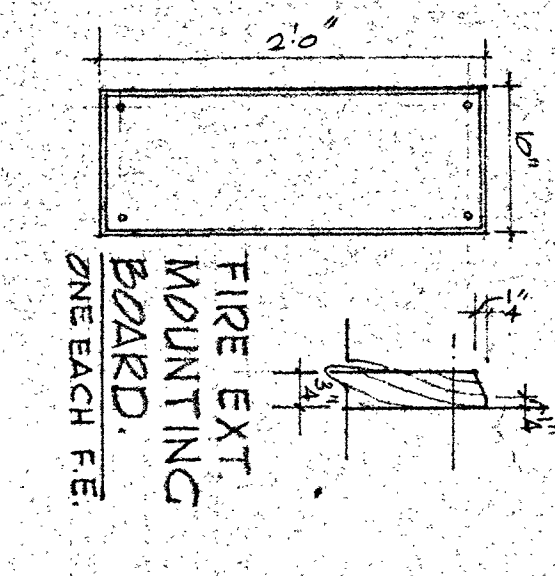

NOTE: OWNER WILL SECURE ALL REQUIRED BUILDING PERMITS.

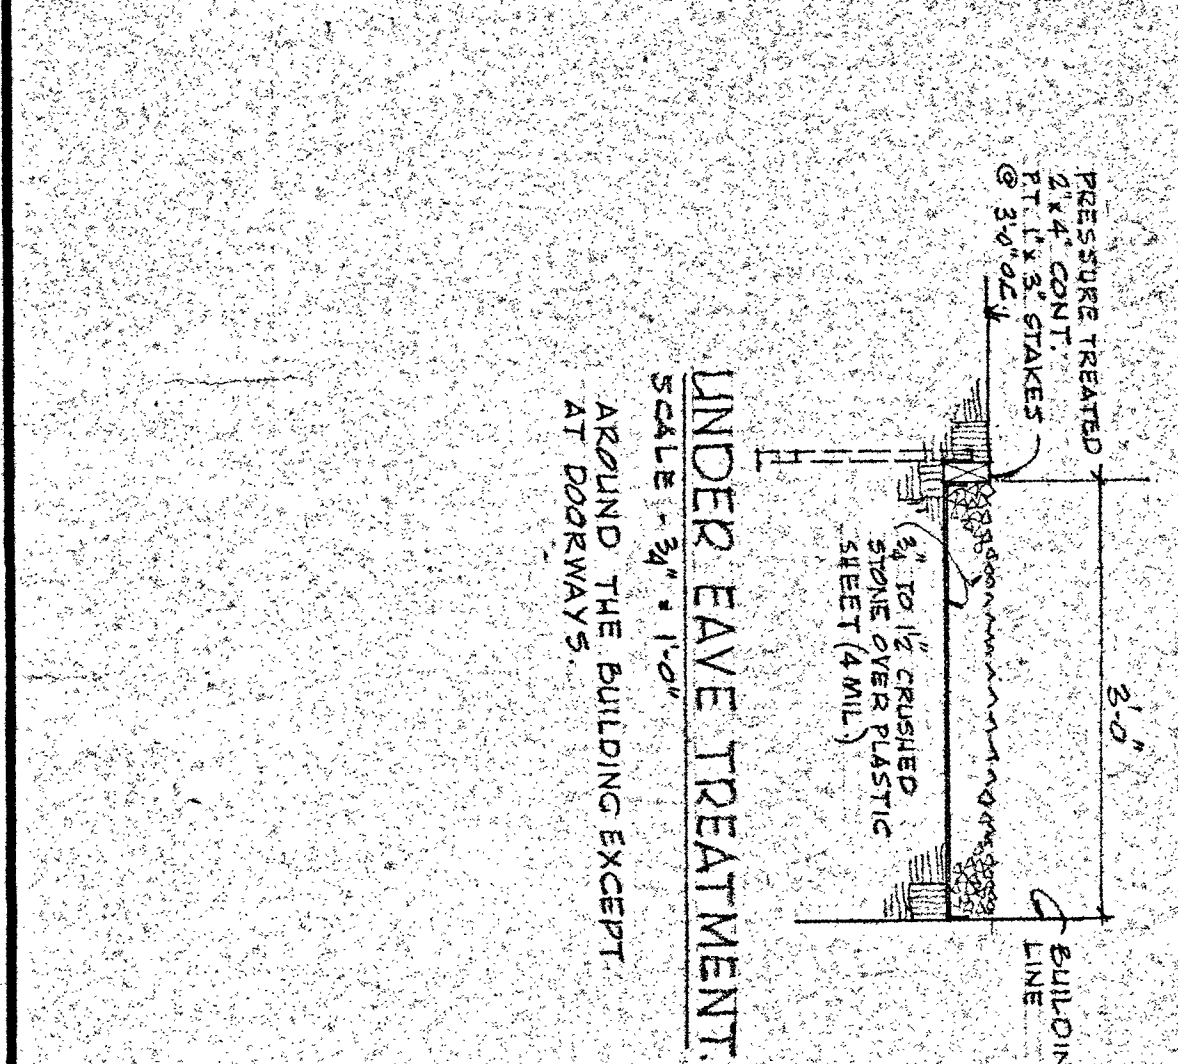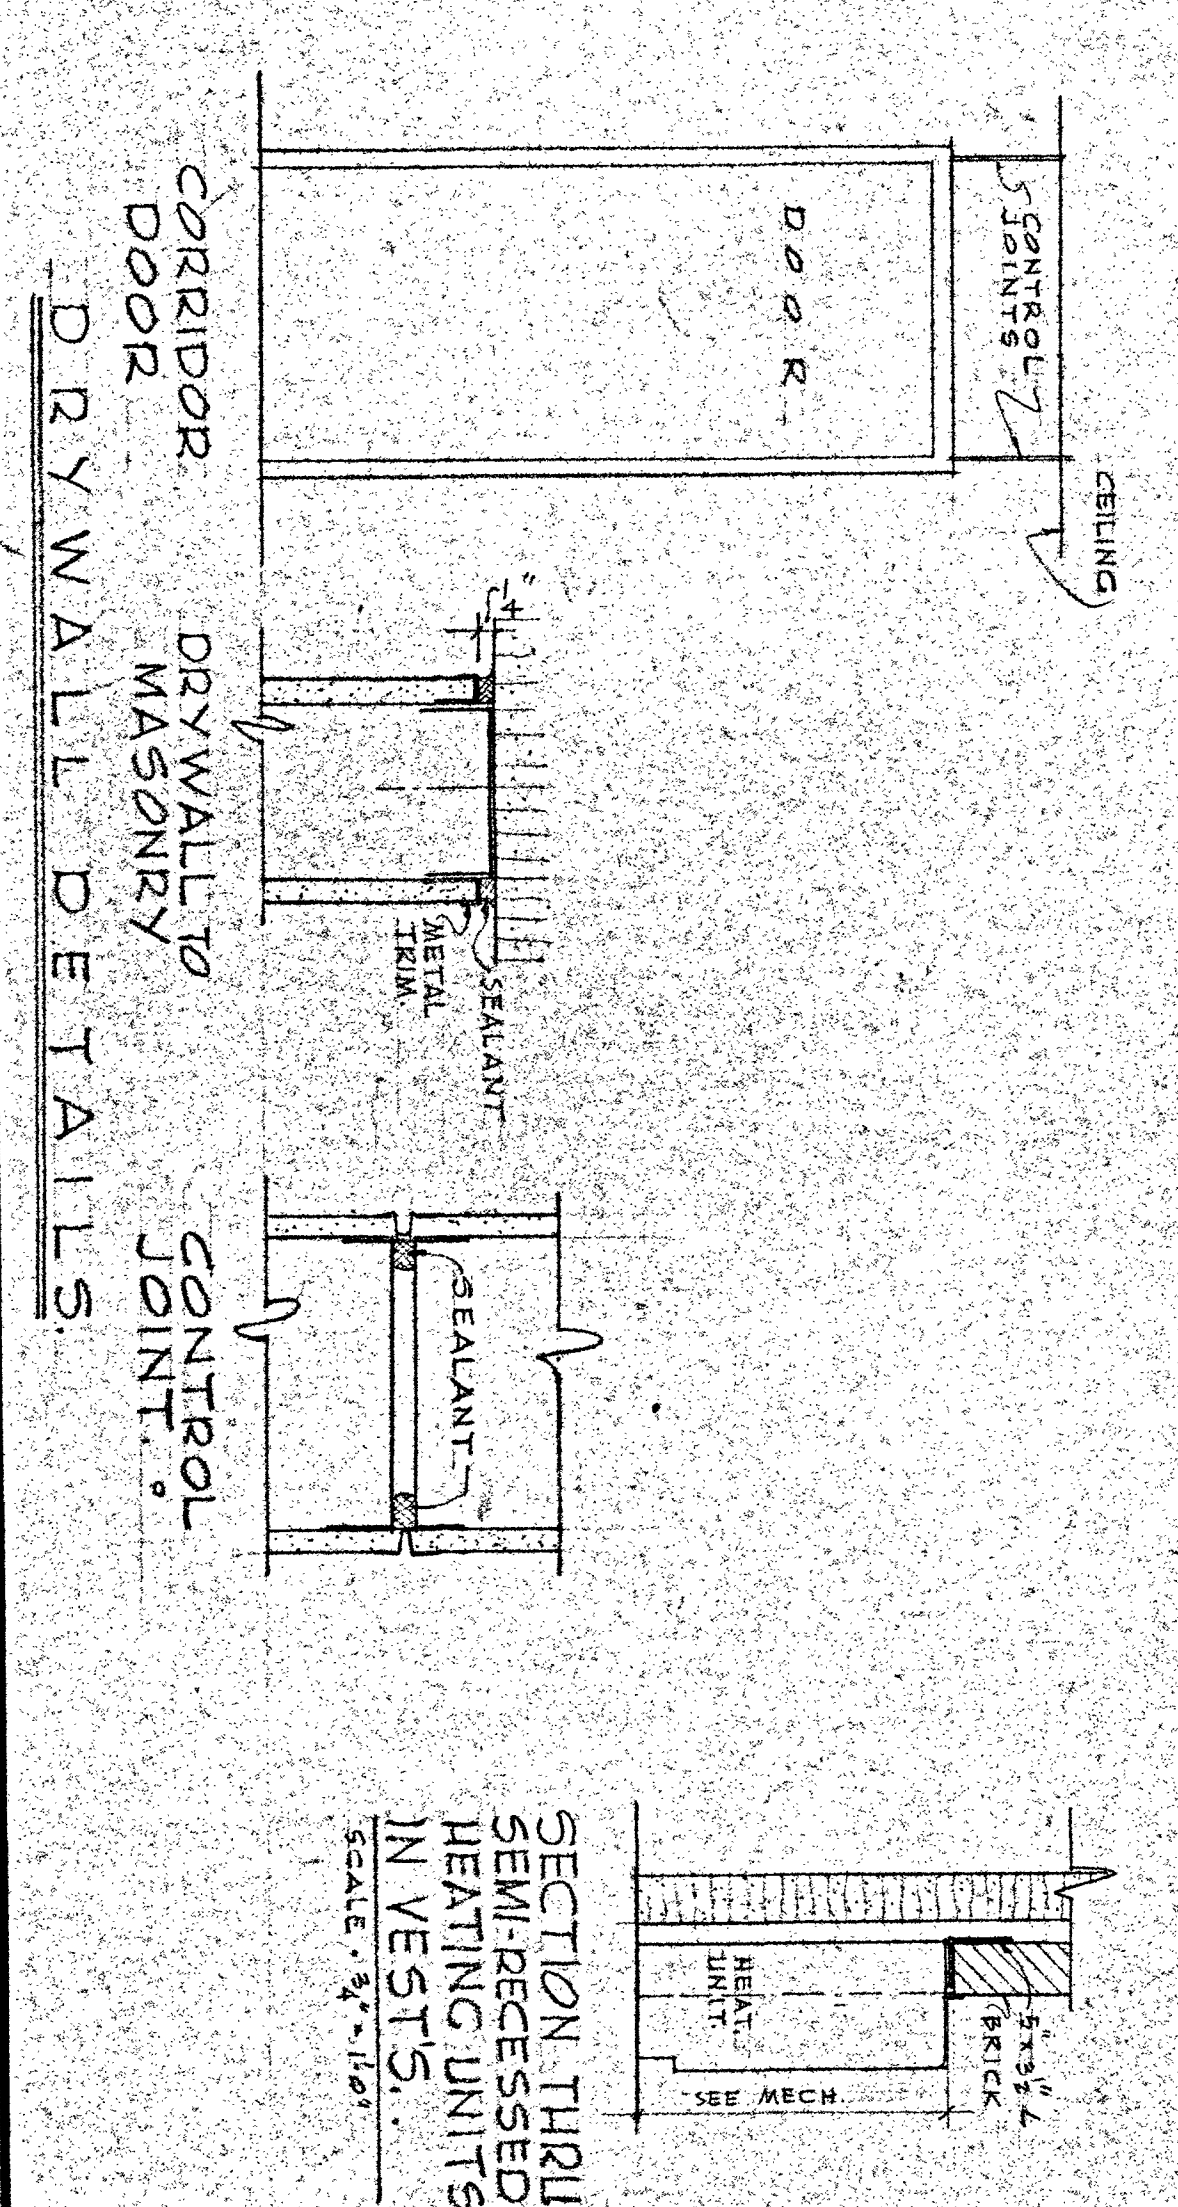

FINISHING NOTES:

1. PAINT OR FINISH ALL INTERIOR EXPOSED SURFACES NOT PREFINISHED.
2. ALL WOOD DOORS ARE PRELIMINARY - PREFINISHED.
3. FLOOR FINISHES SHALL EXTEND UNDER CABINETS & SHELVEING.
4. FINISH CLOSETS SAME AS ADJACENT ROOM.
5. PAINT ALL EXPOSED EXTERIOR WOOD.
6. CARPET BASE 4" HIGH - WITH MARCHER CONE CAP.

JOHANNES & MURRAY & ASSOCIATES
ARCHITECTS
1000 N. W. 10th Ave.
MIAMI, FL 33136
PH: 305-375-1234

CONTINUING EDUCATION BUILDING
ALLGANY COMMUNITY COLLEGE
CUMBERLAND - MARYLAND

DATE: 3-1-77