




SECTION B-B  
SCALE: 3/8" = 1'-0"

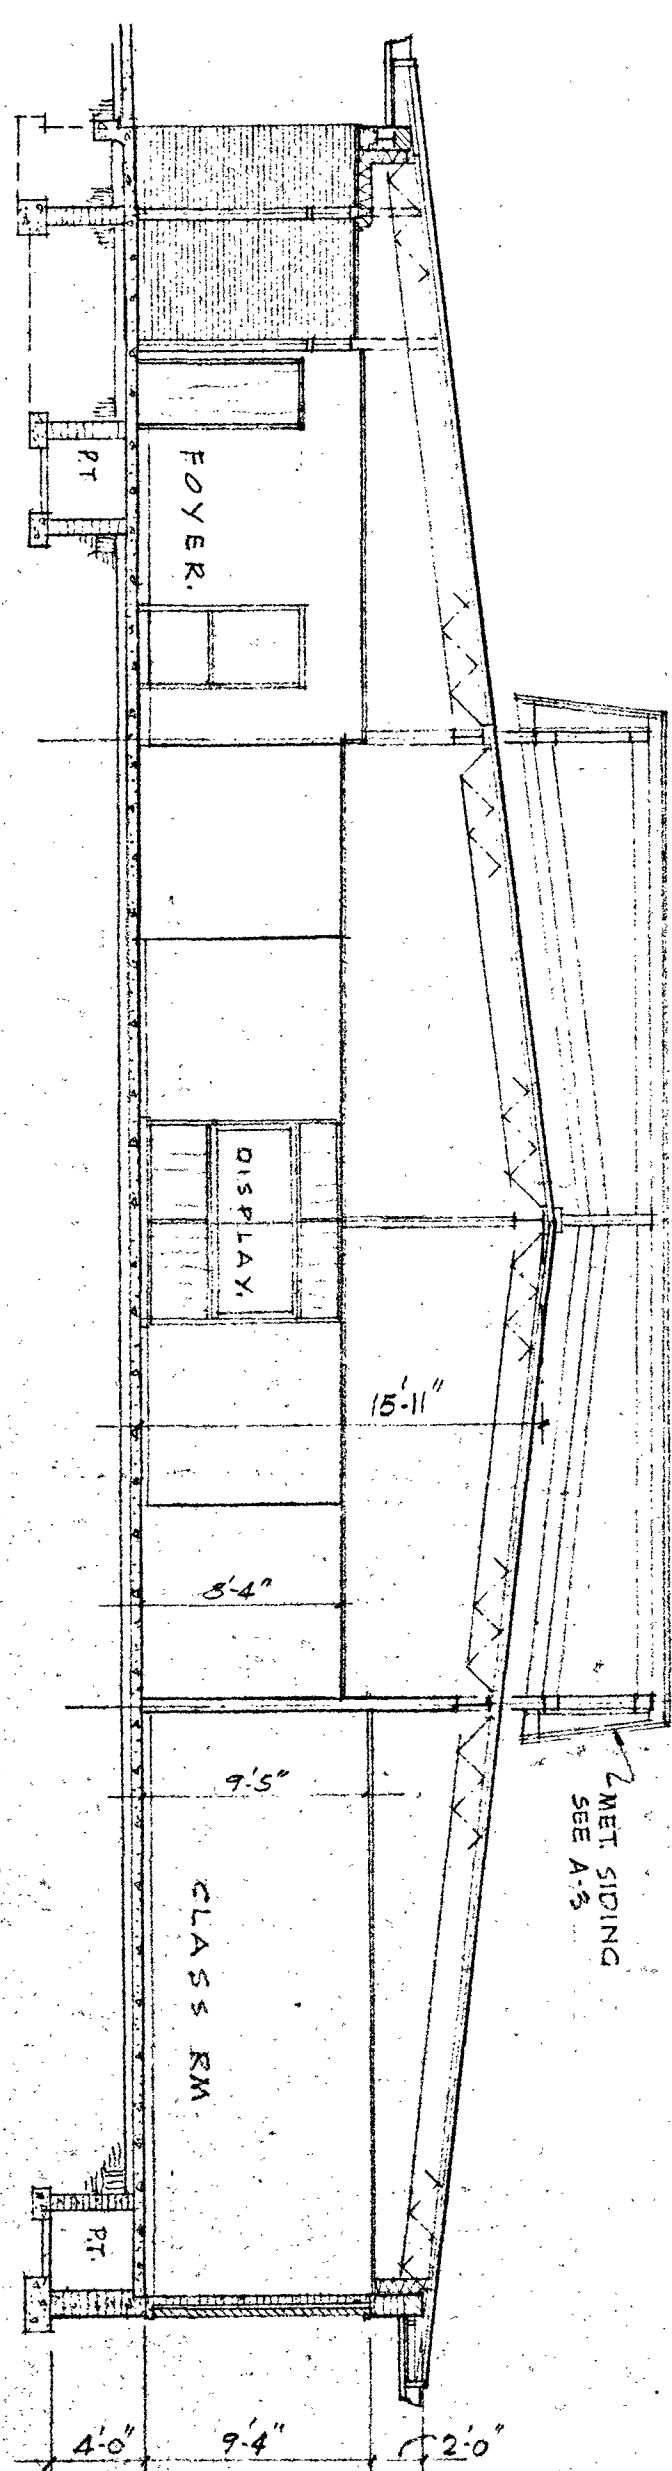


SECTION A-A  
SCALE: 3/8" = 1'-0"

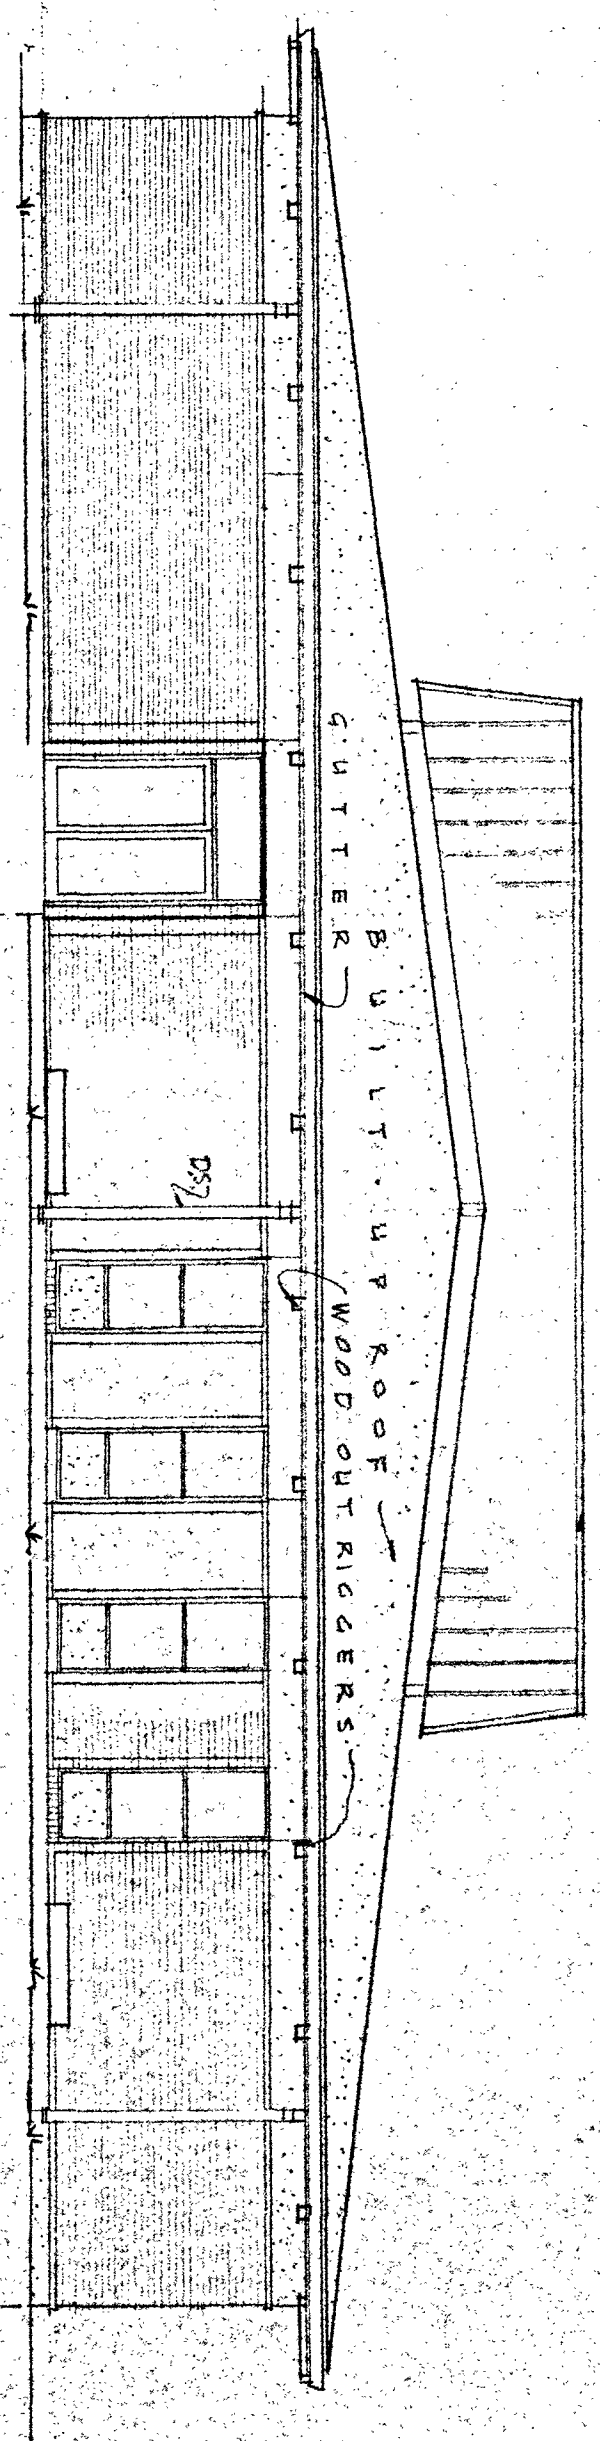


NORTH ELEVATION  
SCALE: 3/8" = 1'-0"

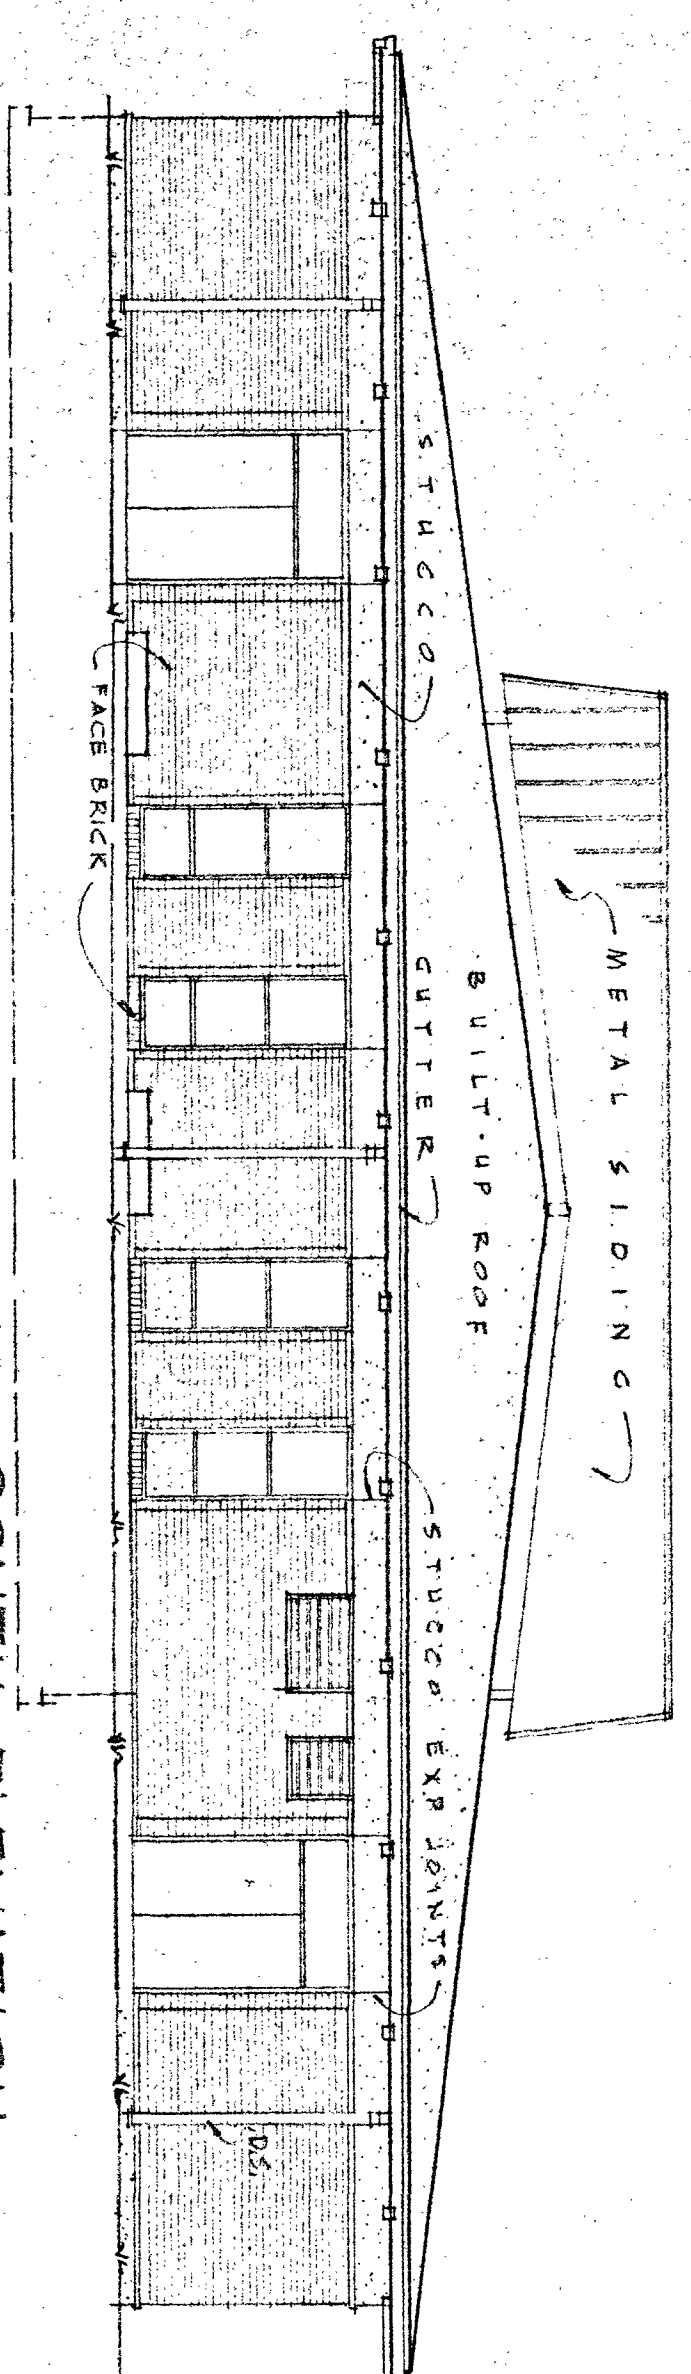


SOUTH ELEVATION  
SCALE: 3/8" = 1'-0"

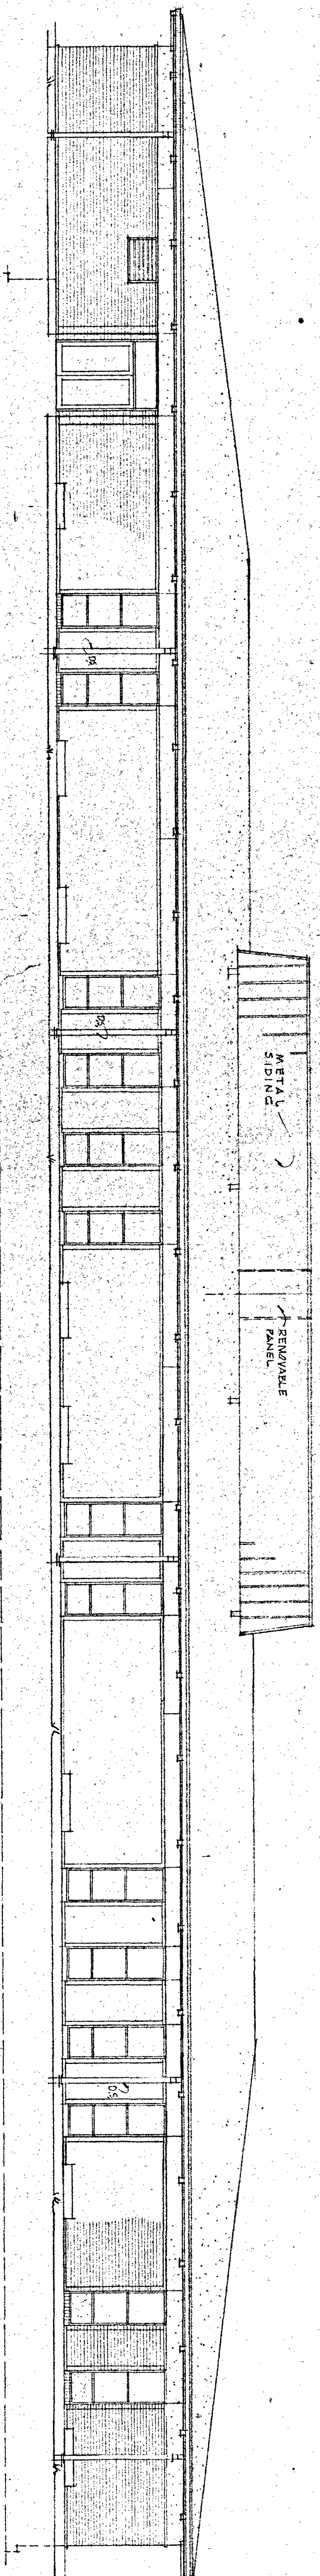

REAR ELEVATION  
SCALE: 3/8" = 1'-0"  
REPEAT NOTES FROM FRONT ELEV.

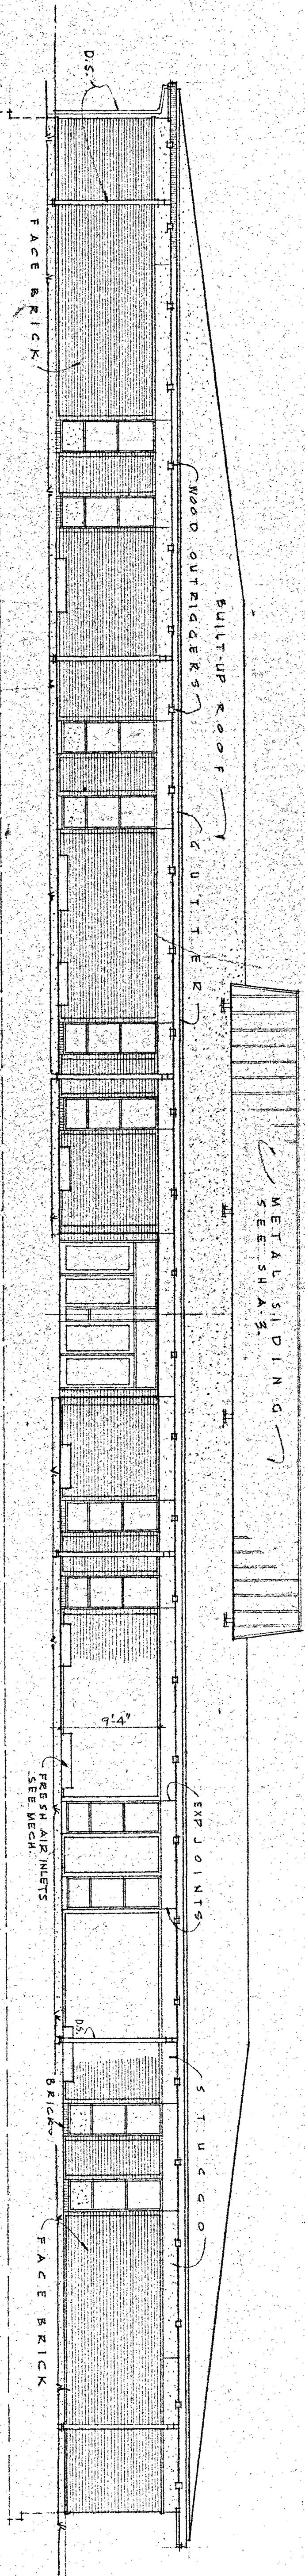

FRONT ELEVATION  
SCALE: 3/8" = 1'-0"

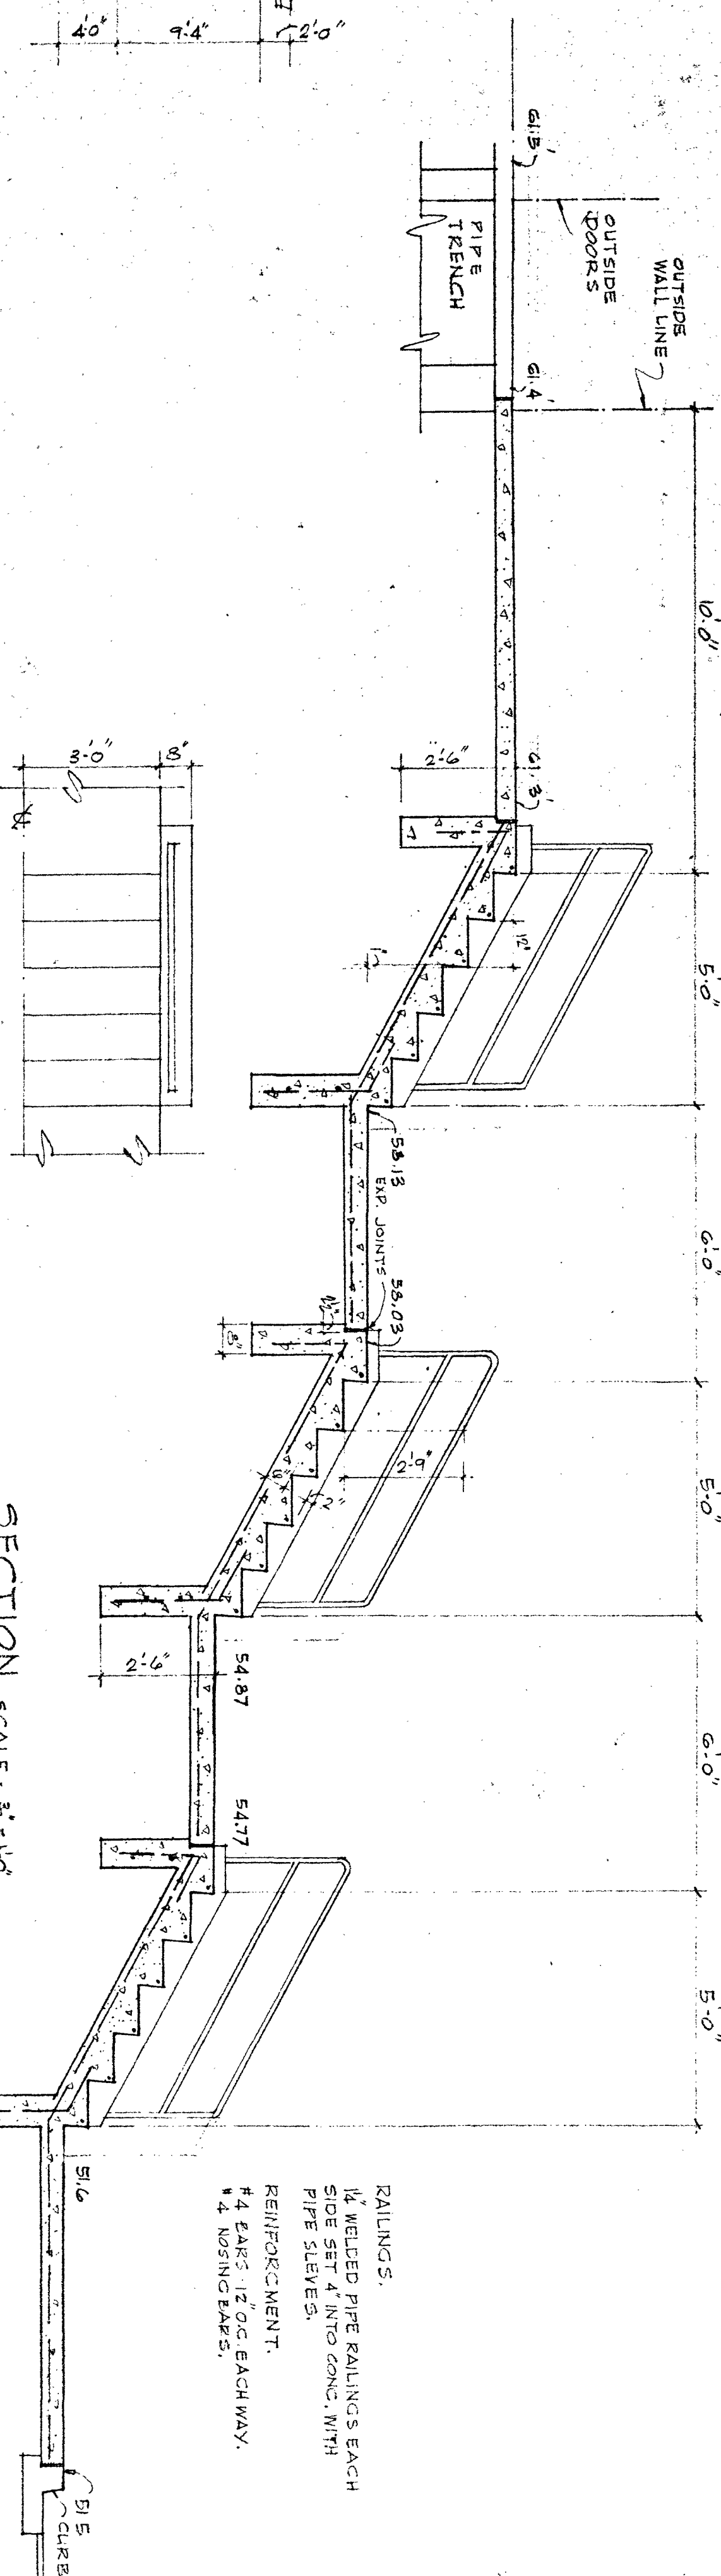

PART PLAN  
SCALE: 3/8" = 1'-0"

SECTION scale: 3/8" = 1'-0"  
DETAIL OF REAR STEPS TO PARKING  
STEPS IN WALL FROM END OF BLDG TO PARKING LOT ARE SIMILAR.

		<b>JOHANNES &amp; MURRAY &amp; ASSOCIATES, INC.</b> 1000 S. 10th St., Suite 100 Milwaukee, WI 53210 414-224-1111		<b>CONTINUING EDUCATION BUILDING</b> ALLEGANY COMMUNITY COLLEGE CUMBERLAND, MARYLAND		CS-5-A DATE: 3/1/77
ARCH: <i>[Signature]</i> DESIGNED: <i>[Signature]</i> DRAWN: <i>[Signature]</i>	APPROVED: <i>[Signature]</i>	A-2 A-4				